


TOWN OF BARNSTABLE

LOCATION 29 Hathaway Rd SEWAGE # 2019-103
 VILLAGE Danville ASSESSOR'S MAP & LOT 119/36
 INSTALLER'S NAME & PHONE NO. Pastore Ex 428-7300
 SEPTIC TANK CAPACITY 1500 gal H2O
 LEACHING FACILITY: (type) 500gal gallys (size) 40x10
 NO. OF BEDROOMS 4
 BUILDER OR OWNER Peter Bilodeau
 PERMIT DATE: _____ COMPLIANCE DATE: 7/15/14

Separation Distance Between the:

Maximum Adjusted Groundwater Table to the Bottom of Leaching Facility _____ Feet
 Private Water Supply Well and Leaching Facility (If any wells exist
 on site or within 200 feet of leaching facility) _____ Feet
 Edge of Wetland and Leaching Facility (If any wetlands exist
 within 300 feet of leaching facility) _____ Feet
 Furnished by Jeff Brown

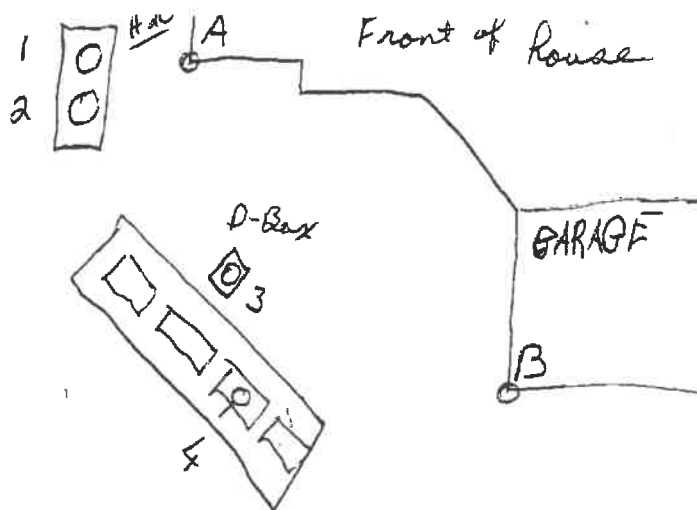

A-1 = 14	B-1 = 99
A-2 = 14.5	B-2 = 94
A-3 = 66.5	B-3 = 44
A-4 = 72.5	B-4 = 39